


PEP 2B FLANGE LOCATIONS

1/21/05
MR JMC

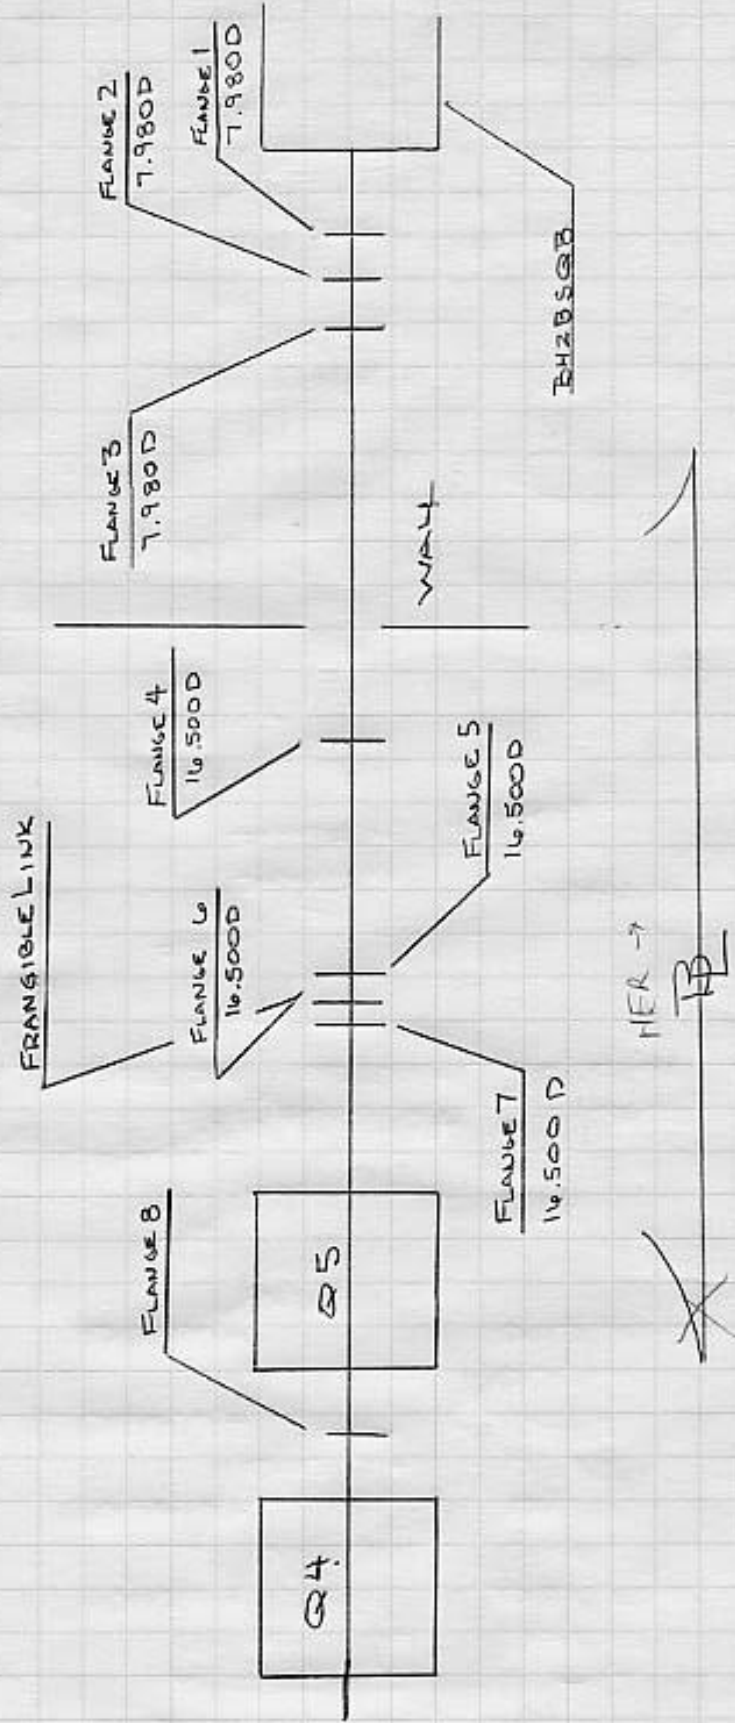

REP 2 B FLANGE
LOCATIONS

1/21/05
3RD MR

TPO1 FLANGE	DIA	OFFSETS		Z DIST, FROM E SQB
		Y	X	
1 M > 1 FLANGE	7.980	+6.000		13.55
2 M >	7.980		+6.000	
3 M > 2 FLANGE	7.980	+6.000		20.25"
4 M >	7.980		+6.480	
5 M > 3 FLANGE	7.980	+6.000		24.30"
6 M >	7.980		+6.480	
7 M > 4 FLANGE	16.500	+6.000		22 1/4" = 265.25"
8 M >	16.500		+6.480	

TPO2	DIA	Y	X	Z DIST
1 M > 5 FLANGE	16.500	+0.750		42'1" 505.0"
2 M >	16.500		+0.750	
6 FLANGE				517.00"
7 FLANGE				529.15"
8 FLANGE	9.980			