

BL1 Coffin Dan Harrington X2564

8-11-03

Perry McDougal

Setting Lexan Lid of Coffin BL 1-4  
-.74 mr

8/12/03

HRLN010 Z 6043.7444 Not in network  
 X 3000.6554  
 Y 574.73444  
 B/L 575.791


Perp o/s BL9-0 to mm  
 HRLN010 .9321 13.9526  
 36.697 549.315  
 SM04W9 1.9382 6.4418  
 inches 76.307 253.614  
 X Z

Spin over HRLN010 of 36.697 LOS  
 sm04w9 76.307 o/s  
 39.610 s/T ✓  
 1.750 ft  
 37.860 s/R ✓

HRLN020 574.74094  
 575.791  
 -41.341  
 5.475  
 57.750

not quite, LOS hits Timber. move over .995

36.697  
 .995  
 37.692 LOS  
 76.307 o/s at sm04w9  
 38.615  
 1.75  
 36.865 s/R

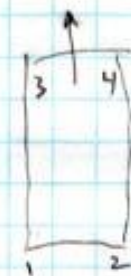

X	v/s	d/s
	37.692	37.692 LOS
	544.013 @ .74 hr	568.513 @ .74 hr
	-.403	-.421 o/s
	1.75	1.75 1/2 window
	39.845 ✓	39.863 ✓
	.175	.175 ft
	39.670 ✓	39.688 s/R
	39.718	39.700 Ad
	39.075	39.050
	3.555	39.555
	39.140	39.690
	39.675 -5	39.705 -17

1	2	3	4
<del>10.266</del>	10.530	10.095	
<del>10.555</del>	<del>10.408</del>	10.170	
10.376	10.376	10.190	
10.374	10.370		
10.235	10.215		
10.185	10.185		