


14-1 Pivot Mask in Alcove Wall

9-30-08

MP JM

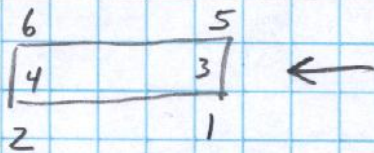

Y

<u>1</u>	<u>2</u>	<u>5</u>	<u>6</u>
10.409	10.409	10.409	10.409
- .488	.481	-.502	.493
10.897	9.928	10.907	9.916
<u>1</u>	<u>1</u>	<u>1</u>	<u>1</u>
9.897 s/r	8.928 s/r	9.907 s/r	8.916 s/r
9.890 +7	8.936 -8	9.899 +8	8.924 -8
9.888 +9	8.927 +1		8.915 +1
	8.925 +3		8.914 +2

X

<u>3</u>	<u>4</u>
-2.009	-2.009
-4.095	-4.497
2.086	2.488
<u>1</u>	<u>1</u>
1.086 s/r	1.488 s/r
1.105 -19	1.492 -4
1.085 +.001	1.488

Z

<u>4</u>
596.631
563.705
32.926
<u>1</u>
31.926 s/r
32.030
32.015 - .089
32.010 - .084