

Drip

8-2-07

FG MR MP BR



QD 134

<u>A</u>	<u>B</u>	<u>C</u>
4.251	4.253	4.259
<u>6.710</u>	<u>6.706</u>	
<u>1.250</u>	<u>1.250</u>	
12.211 ✓	12.209 ✓	

Reg T/B

NOTE: -0.277"
O/S AFTER
VERTICAL BEND
YB120

HI = 12,210

BPM Dia 2,980 Dia R = 1,490

For Val	3.525	Q 164	u/s -	D/s -	+ Mid
Flow	3.525				
	D/s (Q164)	us (QD134)	12.210	12.210	12.210
BPM	12.210	BPM	3.525	3.525	3.525
Radius	1.490	1.490 Rad	8.685	8.685	8.685
	10.720	10.720	.028	.028	.028
	2 splice	10.720	8.713 ✓	8.713	8.713
	8.720 ✓	10.723	-0.277	-0.277	-0.277
Slope cor.	.030	-0.277	8.990	8.990	8.990
	8.750				
	-0.308	11.000 S/R			
	S/R 9.027				
	9.048 FND.	11.040 FND	9.000 FND	8.991 FND	8.977 FND
	-0.021	-0.040	-0.010	-0.001	+0.013

SET QF164

8-2-07

MP BR

3.525
3.525

1st F 3.000 8.000
N 2.273 8.736

U/S
5.448
3.525
1.923

O/S
5.448

2nd F 1.500 10.000
N 1.786 9.735

S/R F 1.923 9.471
N

U/S

O/S

12.996
3.525
9.471

12.996
3.525

LOS 5.448 12.996

4" splice

1st Far 6.000 + 4
Near 9.157 + 1
2nd Far 6.500 + 4
Near 9.405 + 1

+ U/S

+ O/S

13.837
3.525

BY QF164

BPM

13.837

1.5

S/R Far 10.312 - 4 6.312
Near 10.312 - 1 9.312

10.312 ✓
4 splice

12.337

4

LOS 13.837

S/R 6.312 ✓
6.442

6.312
6.455

S/R 8.337

8.467 8.357

-1.130

-1.143

-1.130

-1.020


BY QF164
BPM

LOCATION LTEN
ELEMENT VE164

GIRDER # LTEN 1

PAGE # 3

DATE 1/20/89
OPERATORS BW, TR

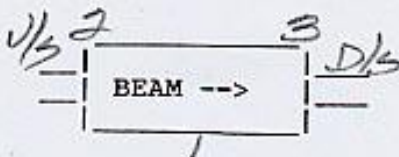

"Y" RIVET # TBM
SCALE READING 16.797
PLUS ADAPTER 57. -
= 73.797
RIVET VAL. - 65.387
HI = 8.410

"Y" RIVET # _____
SCALE READING _____
PLUS ADAPTER _____
= _____
RIVET VAL. - _____
HI = _____

AVG. HI = _____

FID#	FID#	FID#	FID#
<u>1</u>	<u>2</u>	<u>3</u>	_____
HI = <u>8.410</u>	HI = <u>8.410</u>	HI = <u>8.410</u>	HI = _____
FID. VAL <u>3.525</u>	FID. VAL <u>3.525</u>	FID. VAL <u>3.525</u>	FID. VAL _____
= <u>4.945</u>	= <u>4.945</u>	= <u>4.945</u>	= _____
FT/ROD <u>-.277</u>	FT/ROD <u>-.277</u>	FT/ROD <u>-.277</u>	FT/ROD _____
S/R <u>5.222</u>	S/R <u>5.222</u>	S/R <u>5.222</u>	S/R _____
READ <u>5.217</u>	READ <u>5.220</u>	READ <u>5.224</u>	READ _____
FOUND <u>+ .005</u>	FOUND <u>+ .002</u>	FOUND <u>- .002</u>	FOUND _____
SET _____	SET _____	SET _____	SET _____

X" MON. # _____ / VAL. _____
MON. # _____ / VAL. _____

BUCKIN PROGRAM

1st _____ 2nd _____
3rd _____ 4th _____

L.O.S. = _____

(CHECK) MON # _____ VAL. _____
L.O.S. _____
S/R _____
READ _____

MON. # _____ S/R _____
MON. # _____ S/R _____


FID #	FID #	FID #	FID #
<u>4/3</u>	<u>D/3</u>	_____	_____
L.O.S. <u>16.786</u>	L.O.S. <u>16.786</u>	L.O.S. _____	L.O.S. _____
FID. <u>3.525</u>	FID. <u>3.525</u>	FID. _____	FID. _____
= <u>13.261</u>	= <u>13.261</u>	= _____	= _____
FT. _____	FT. _____	FT. _____	FT. _____
S/R <u>13.261</u>	S/R <u>13.261</u>	S/R _____	S/R _____
READ <u>13.264</u>	READ <u>13.265</u>	READ _____	READ _____
FOUND <u>- .003</u>	FOUND <u>- .004</u>	FOUND _____	FOUND _____
SET _____	SET _____	SET _____	SET _____

LOCATION LTEN
ELEMENT WD 134

GIRDER # LTEN1

PAGE # 2

DATE 11/20/89
OPERATORS B.W. J.R.

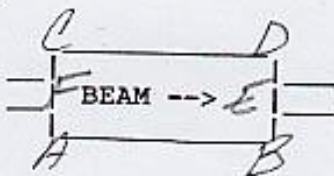

"y" RIVET # B0240
SCALE READING 14.343
PLUS ADAPTER .57
= 14.913
RIVET VAL. - 61.843
HI = 9.500

"y" RIVET # _____
SCALE READING _____
PLUS ADAPTER _____
= _____
RIVET VAL. - _____
HI = _____

AVG. HI = _____

FID# <u>A</u>	FID# <u>B</u>	FID# <u>C</u>	FID# <u>D</u>
HI = <u>9.500</u>	HI = <u>9.500</u>	HI = <u>9.500</u>	HI = <u>9.500</u>
FID. VAL <u>4.251</u>	FID. VAL <u>4.253</u>	FID. VAL <u>4.259</u>	FID. VAL <u>4.255</u>
= <u>3.249</u>	= <u>3.247</u>	= <u>3.241</u>	= <u>3.245</u>
FT/ROD <u>1.</u>	FT/ROD <u>1.</u>	FT/ROD <u>1.</u>	FT/ROD <u>1.</u>
S/R <u>4.249</u>	S/R <u>4.247</u>	S/R <u>4.241</u>	S/R <u>4.245</u>
READ <u>4.249</u>	READ <u>4.247</u>	READ <u>4.247</u>	READ _____
FOUND <u>0</u>	FOUND <u>-.002</u>	FOUND <u>-.006</u>	FOUND _____
SET _____	SET _____	SET _____	SET _____

X" MON. # _____ / VAL. _____
MON. # _____ / VAL. _____

BUCKIN PROGRAM

1st _____ 2nd _____
3rd _____ 4th _____

L.O.S. = _____

(CHECK) MON # _____ VAL. _____
L.O.S. _____
S/R _____
READ _____

MON. # _____ S/R _____
MON. # _____ S/R _____


FID # <u>E</u>	FID # <u>F</u>	FID # _____	FID # _____
L.O.S. <u>16.786</u>	L.O.S. <u>16.786</u>	L.O.S. _____	L.O.S. _____
FID. <u>11.075</u>	FID. <u>11.057</u>	FID. _____	FID. _____
= <u>27.861</u>	= <u>27.943</u>	= _____	= _____
FT. <u>19.</u>	FT. <u>19.</u>	FT. _____	FT. _____
S/R <u>8.861</u>	S/R <u>8.803</u>	S/R _____	S/R _____
READ <u>8.851</u>	READ <u>8.838</u>	READ _____	READ _____
FOUND <u>+.010</u>	FOUND <u>+.025</u>	FOUND _____	FOUND _____
SET _____	SET _____	SET _____	SET _____

LOCATION LTEN
 ELEMENT RD 804

GIRDER # 2 LTEN

PAGE # 4

DATE 11/20/89
 OPERATORS B.W. F.R.
M.D. J.H.

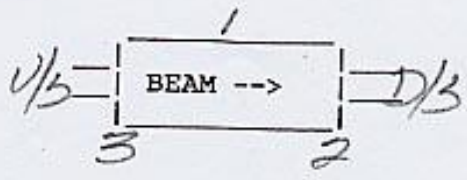

"Y" RIVET # _____
 SCALE READING _____
 PLUS ADAPTER _____
 = _____
 RIVET VAL. - _____
 HI= SEE PG 3

"Y" RIVET # _____
 SCALE READING _____
 PLUS ADAPTER _____
 = _____
 RIVET VAL. - _____
 HI= _____

AVG. HI= _____

FID#	FID#	FID#	FID#
<u>1</u>	<u>2</u>	<u>3</u>	_____
HI= <u>8.470</u>	HI= <u>8.470</u>	HI= <u>8.470</u>	HI= _____
FID. VAL <u>3.525</u>	FID. VAL <u>3.525</u>	FID. VAL <u>3.525</u>	FID. VAL _____
= <u>4.945</u>	= <u>4.945</u>	= <u>4.945</u>	= _____
FT/ROD <u>.263</u>	FT/ROD <u>.263</u>	FT/ROD <u>.263</u>	FT/ROD _____
S/R <u>5.208</u>	S/R <u>5.208</u>	S/R <u>5.208</u>	S/R _____
READ <u>5.203</u>	READ <u>5.203</u>	READ <u>5.204</u>	READ _____
FOUND <u>+ .005</u>	FOUND <u>+ .005</u>	FOUND <u>+ .004</u>	FOUND _____
SET _____	SET _____	SET _____	SET _____

X" MON. # 2A /VAL. 11.980
 MON. # 2B /VAL. 13.273

L.O.S. = 13.273

(CHECK) MON # _____ VAL. _____
 L.O.S. _____
 S/R _____
 READ _____

BUCKIN PROGRAM

1st _____ 2nd _____
 3rd _____ 4th _____
 MON. # _____ S/R _____
 MON. # _____ S/R _____


FID #	FID #	FID #	FID #
<u>1/3</u>	<u>1/3</u>	_____	_____
L.O.S. <u>13.273</u>	L.O.S. <u>13.273</u>	L.O.S. _____	L.O.S. _____
FID. <u>3.525</u>	FID. <u>3.525</u>	FID. _____	FID. _____
= <u>4.748</u>	= <u>4.748</u>	= _____	= _____
FT. <u>5.</u>	FT. <u>5.</u>	FT. _____	FT. _____
S/R <u>4.748</u>	S/R <u>4.748</u>	S/R _____	S/R _____
READ <u>4.734</u>	READ <u>4.736</u>	READ _____	READ _____
FOUND <u>+ .014</u>	FOUND <u>+ .012</u>	FOUND _____	FOUND _____
SET _____	SET _____	SET _____	SET _____

LOCATION LTAN
 ELEMENT QF254

GIRDER # LTAN 2

PAGE # 5

DATE 1/20/89
 OPERATORS
B.W. F.R.

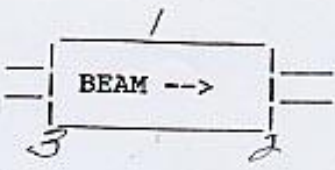

"Y" RIVET # _____
 SCALE READING _____
 PLUS ADAPTER _____
 = _____
 RIVET VAL. - _____
 HI= Set pg 3

"Y" RIVET # _____
 SCALE READING _____
 PLUS ADAPTER _____
 = _____
 RIVET VAL. - _____
 HI= _____

AVG. HI= _____

FID#	FID#	FID#	FID#
<u>1</u>	<u>2</u>	<u>3</u>	<u>3</u>
HI= <u>8.470</u>	HI= <u>8.470</u>	HI= <u>8.470</u>	HI= _____
FID. VAL <u>3.525</u>	FID. VAL <u>3.525</u>	FID. VAL <u>3.525</u>	FID. VAL _____
= <u>4.945</u>	= <u>4.945</u>	= <u>4.945</u>	= _____
FT/ROD <u>-1.230</u>	FT/ROD <u>-1.234</u>	FT/ROD <u>-1.234</u>	FT/ROD _____
S/R <u>5.179</u>	S/R <u>5.179</u>	S/R <u>5.179</u>	S/R _____
READ <u>5.189</u>	READ <u>5.186</u>	READ <u>5.188</u>	READ _____
FOUND <u>-0.010</u>	FOUND <u>-0.007</u>	FOUND <u>-0.009</u>	FOUND _____
SET _____	SET _____	SET _____	SET _____


X" MON. # _____ / VAL. Suppage 4
 MON. # _____ / VAL. _____

BUCKIN PROGRAM
 1st _____ 2nd _____
 3rd _____ 4th _____
 MON. # _____ S/R _____
 MON. # _____ S/R _____

L.O.S.= _____
 (CHECK) MON # _____ VAL. _____
 L.O.S. _____
 S/R _____
 READ _____

FID #	FID #	FID #	FID #
L.O.S. <u>13.273</u>	L.O.S. <u>13.273</u>	L.O.S. _____	L.O.S. _____
FID. <u>3.525</u>	FID. <u>3.525</u>	FID. _____	FID. _____
= <u>4.748</u>	= <u>4.748</u>	= _____	= _____
FT. <u>5. -</u>	FT. <u>5. -</u>	FT. _____	FT. _____
S/R <u>4.748</u>	S/R <u>4.748</u>	S/R _____	S/R _____
READ <u>4.734</u>	READ <u>4.734</u>	READ _____	READ _____
FOUND <u>1.014</u>	FOUND <u>1.014</u>	FOUND _____	FOUND _____
SET _____	SET _____	SET _____	SET _____

Pitch $.02577^\circ$ $.000449$ rad

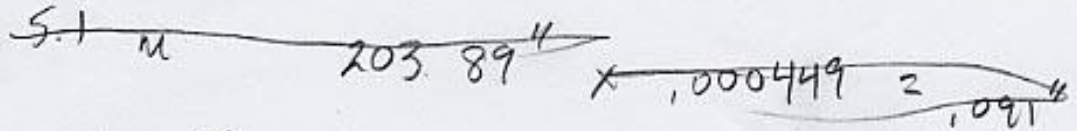

$$62.00 \times .000449 = .028 \text{ ''}$$

JIM CLENDENIN

424 7133

Henry
2180

DN00	NLTR00	05			0	0	1- 2
DN00SB0		SB0			1	1	
DN00MPB		MPB			1	1	
DN00FBL		PBL			1	1	
DN00PBR		PBR			1	1	
DN01	NLTR01	06			0	0	1- 2
DN01VB1		VB120	B120	VB53N	1	1	
DN01QU1		QD134	Q134	QD53BN	1	1	
DN01XX1		XC160	X160		1	1	
DN01WS1		WS			1	1	
DN01QU2		QP164	Q164	QP53BN	1	1	
DN02	NLTR02	09			0	0	1- 2
DN02MR1		PR1N	P194		1	1	
DN02QU1		QD204	Q204	QD53AN	1	1	
DN02YY1		YC210	Y210		1	1	
DN02QU2		QP254	Q254	QP53AN	1	1	
DN02YY2		YC274	Y274		1	1	
DN02BD1		B280	B280	B49N	1	1	
DN02QU3		QD284	Q284	QD49N	1	1	
DN02BD2		B290	B290	B47N	1	1	
DN03	NLTR03	07			0	0	3-10
DN03QU1		QP334	Q334	QP47N	1	1	
DN03XX1		XC340	X340		1	1	
DN03VB1		VB370	B370	VB51N	1	1	
DN03QU2		QD384	Q384	QD45N	1	1	
DN03VB2		VB450	B450	VB45N	1	1	
DN03MR1		PR4N	P480		1	1	
DN05	NLTR05	08			0	0	3-10
DN05BD1		B510	B510	B43N	1	1	
DN05QU1		QP524	Q524	QP43N	1	1	
DN05BD2		B530	B530	B41N	1	1	
DN05BD3		B550	B550	B39N	1	1	
DN05QU2		QD564	Q564	QD39N	1	1	
DN05BD4		B570	B570	B37N	1	1	
DN05BD5		B590	B590	B35N	1	1	
DN06	NLTR06	08			0	0	4-18- 3
DN06QU1		QP604	Q604	QP35N	1	1	
DN06BD1		B620	B620	B33N	1	1	
DN06BD2		B640	B640	B31N	1	1	
DN06QU2		QD654	Q654	QD31N	1	1	
DN06BD3		B660	B660	B29N	1	1	
DN06BD4		B680	B680	B27N	1	1	
DN06QU3		QP694	Q694	QP27N	1	1	
DN07	NLTR07	08			0	0	19- 4- 5
DN07BD1		B710	B710	B25N	1	1	
DN07BD2		B730	B730	B23N	1	1	
DN07QU1		QD744	Q744	QD23N	1	1	
DN07BD3		B750	B750	B21N	1	1	
DN07BD4		B770	B770	B19N	1	1	
DN07QU2		QP774	Q774	QP19N	1	1	
DN07BD5		B790	B790	B17N	1	1	
DN08	NLTR08	09			0	0	5-19- 6
DN08YY1		YC810	Y810		1	1	
DN08QU1		QD814	Q814	QD17DN	1	1	
DN08QU2		QP834	Q834	QP17CN	1	1	
DN08XX1		XC840	X840		1	1	
DN08QU3		QD854	Q854	QD17CN	1	1	
DN08QU4		QP874	Q874	QP17BN	1	1	
DN08YY2		YC890	Y890		1	1	
DN08QU5		QD894	Q894	QD17BN	1	1	
DN09	NLTR09	10			0	0	5-19- 6
DN09QU1		QP914	Q914	QP17AN	1	1	
DN09XX1		XC920	X920		1	1	
DN09QU2		QD934	Q934	QD17AN	1	1	
DN09XX2		XC940	X940		1	1	
DN09BD1		B950	B950	B15N	1	1	
DN09QU3		QP954	Q954	QP15N	1	1	
DN09BD2		B960	B960	B13N	1	1	
DN09QU4		QD974	Q974	QD13DN	1	1	
DN09YY1		YC980	Y980		1	1	
DN10	NLTR10	10			0	0	5- 6
DN10XX1		XC1012	X012		1	1	
DN10QU1		QP1014	Q014	QP13CN	1	1	
DN10QU2		QD1024	Q024	QD13CN	1	1	
DN10YY1		YC1030	Y030		1	1	
DN10CP1		PC1050	P050		1	1	
DN10SR1		SOL1060	R060		1	1	
DN10MP1			M070		1	1	
DN10XX2		XC1080	X080		1	1	
DN10YY2		YC1090	Y090		1	1	
DN11	NLTR11	10			0	0	5- 6
DN11MR1		PR10N	P100		1	1	
DN11YY1		YC1102	Y102		1	1	
DN11QU1		QD1104	Q104	QD13BN	1	1	
DN11QU2		QP1114	Q114	QP13BN	1	1	
DN11XX1		XC1120	X120		1	1	
DN11QU3		QD1164	Q164	QD13AN	1	1	
DN11YY2		YC1170	Y170		1	1	
DN11XX2		XC1190	X190		1	1	
DN11QU4		QP1194	Q194	QP13AN	1	1	