

(Y)

SSRL B/L G
STOPPER

11-12-04
J.M., L.G.

Pivot support

(+)

16.906
.250 R

16.656 S/R
16.650
+006

set Pivot Pt @ B/L

(-)

16.656 S/R
16.660

-004

Y

S&RL B/L 6
STOPPER

11-11-04
J.M., L.G.

HRL 5010

$$\begin{array}{r}
 574.74884 \text{ EL.} \\
 575.7911 \text{ B/L} \\
 \hline
 -1.04226 \text{ m} = -41.034'' \\
 \hline
 17.190 \\
 40.750 \\
 57.940 \\
 \hline
 +16.906 \text{ HT}
 \end{array}$$

PLATE 4 LEAD

$$\begin{array}{r}
 16.906 \\
 \leftarrow 16.000 \\
 \hline
 22.906 \\
 +1.980 \text{ OFFSET} \\
 \hline
 20.926
 \end{array}$$

$$\begin{array}{r}
 \text{u/s) } 16.906 \\
 2.233 \text{ RADIUS} \\
 \hline
 14.673
 \end{array}$$

$$\begin{array}{r}
 \text{d/s) } 16.906 \\
 2.233 \\
 \hline
 14.673
 \end{array}$$

$$\begin{array}{r}
 (+) 1.980 \text{ OFFSET} \\
 \hline
 12.693 \text{ S/R}
 \end{array}$$

$$\begin{array}{r}
 1.980 \\
 \hline
 12.693 \text{ S/R}
 \end{array}$$

$$\begin{array}{r}
 12.683 \\
 \hline
 +010
 \end{array}$$

$$\begin{array}{r}
 12.293 \\
 \hline
 \phi
 \end{array}$$


Roll

(+)	-	(-)
7.970		7.970

A) +.050

20.760

A

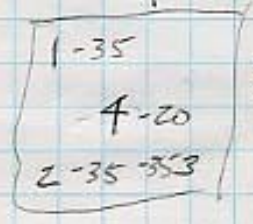

X) +19.685 LOS (1/2 M)

$$\begin{array}{r}
 \text{u/s) } 19.685 \\
 2.233 \\
 \hline
 17.452 \text{ S/R}
 \end{array}$$

$$\begin{array}{r}
 \text{d/s) } 19.685 \\
 2.233 \\
 \hline
 17.452 \text{ S/R}
 \end{array}$$

17.447

17.455

$$\begin{array}{r}
 \hline
 +.005
 \end{array}$$

$$\begin{array}{r}
 \hline
 -.003
 \end{array}$$

- 1) 20.961 - 035
- 2) 20.960 - 034
- 3) 20.962 - 036
- 4) 20.950 - 024

A) 17.452 S/R

B) 17.452 S/R

17.456

17.435

$$\begin{array}{r}
 \hline
 -.004
 \end{array}$$

$$\begin{array}{r}
 \hline
 +.017
 \end{array}$$

$$\begin{array}{r}
 19.685 \\
 1.215 \\
 \hline
 18.470 \text{ S/R}
 \end{array}$$

$$\begin{array}{r}
 18.200 \\
 \hline
 +.270
 \end{array}$$

