SLM FRONT END ALIGNMENT

C. LeCocq
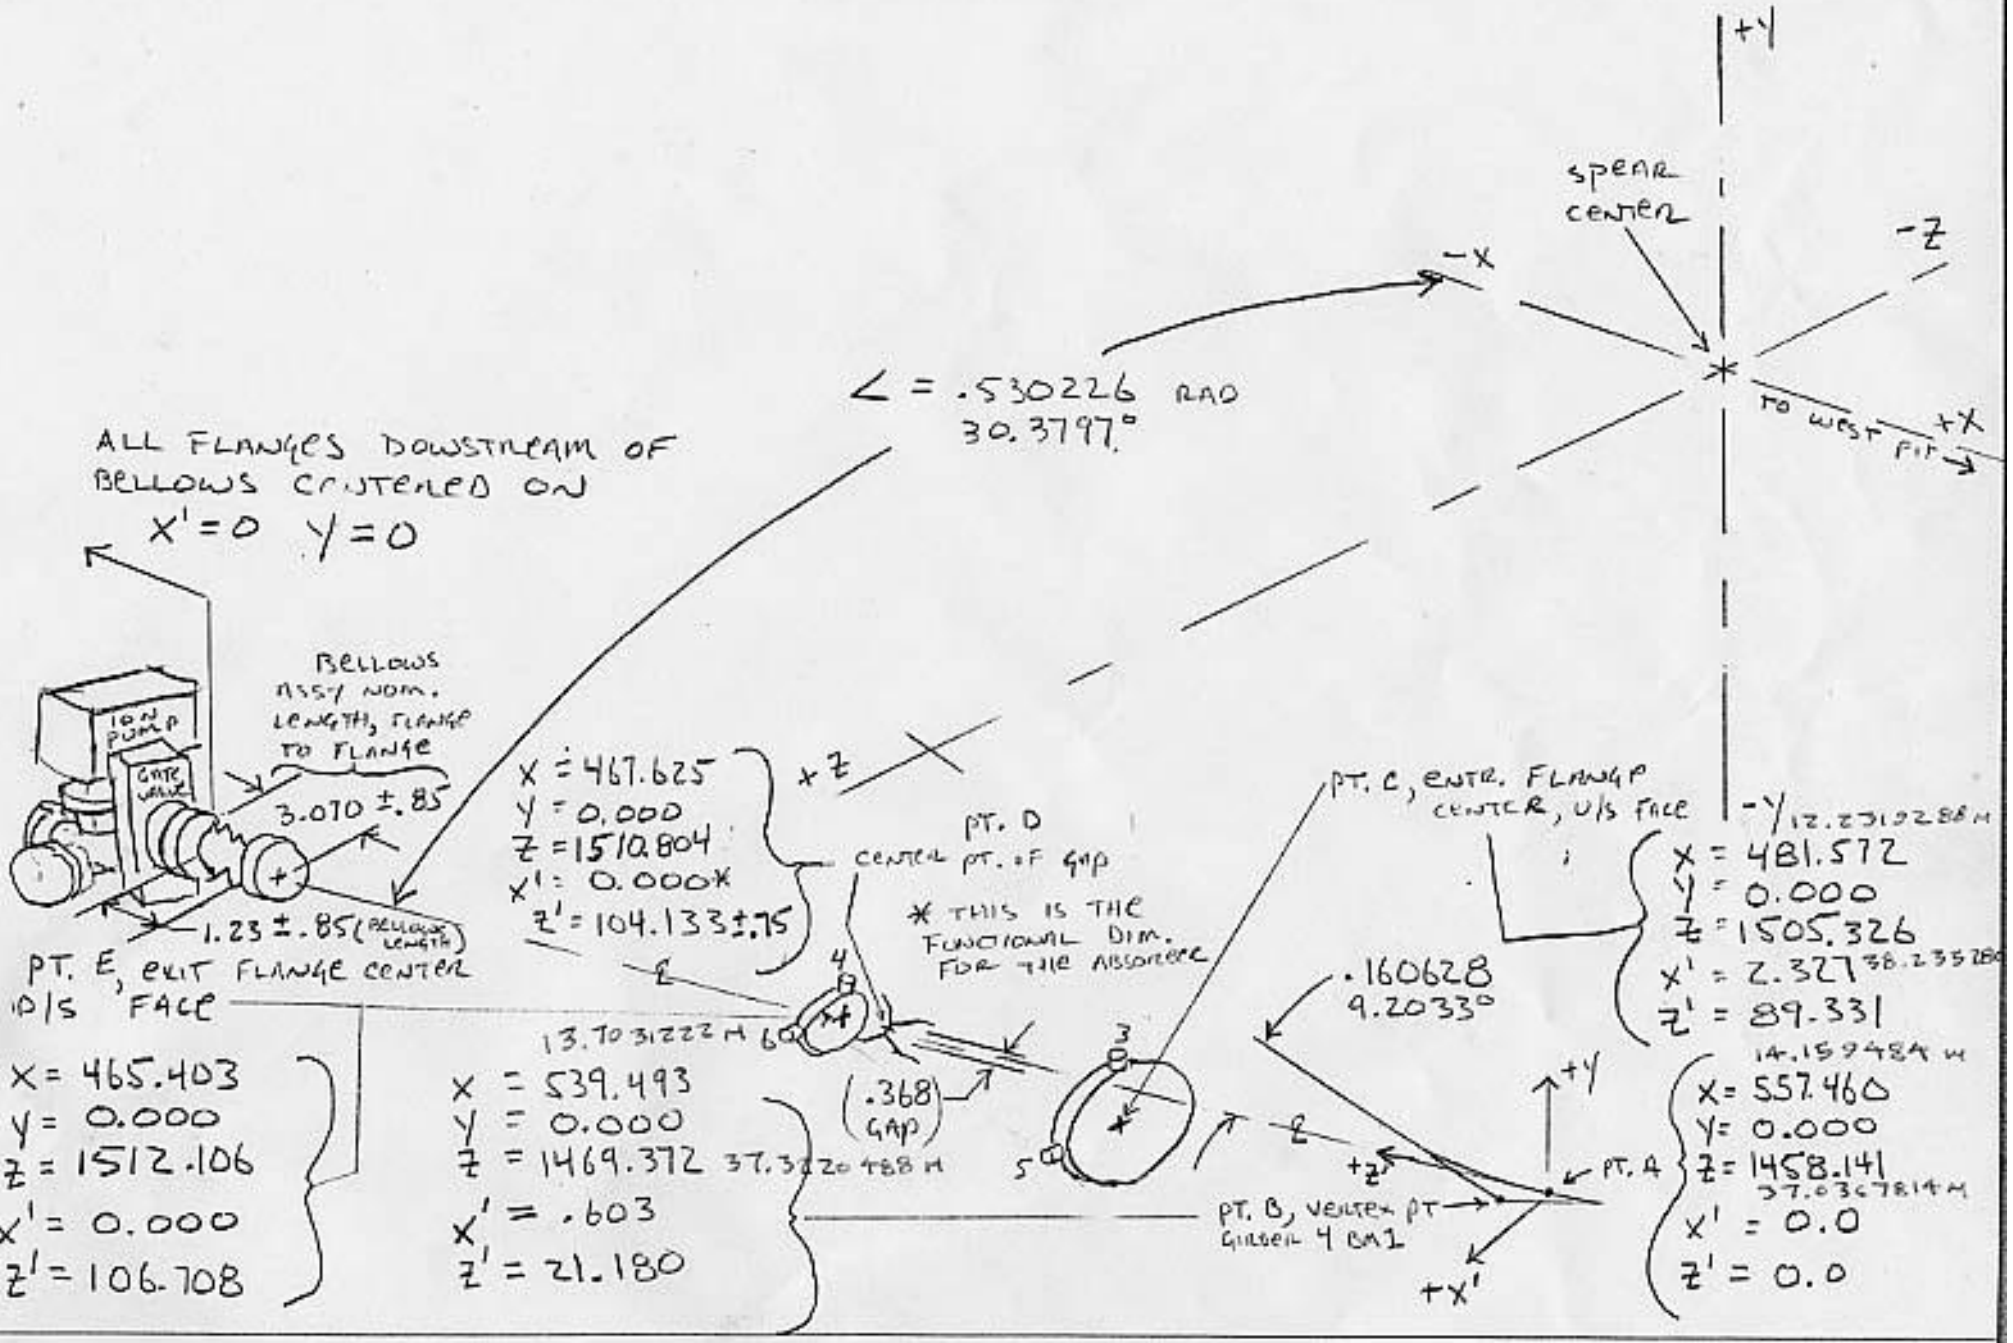
ADL 9/30/03